



Colliers International
1850 Mount Diablo Boulevard, Suite 200
Walnut Creek, CA 94596 | United States
www.colliers.com

LEASING AGENT

Matt Hurd
(925) 279-5567

matt.hurd@colliers.com

Scott Ellis
(925) 279-5575

scott.ellis@colliers.com

**1600
South Main Plaza**
Walnut Creek, CA

Third Floor

Managed by:

**WCSI
Properties LLC**

Approximate Area Calculations
Subject To Verification:

2,004 rsf


As-built Plan To Be Verified

This information displayed while not guaranteed has been secured by sources we believe to be reliable. This information is subject to errors & omissions. Any tenant should conduct their own investigation.


Plan Revision - 2-3-25

1600 SOUTH MAIN
WALNUT CREEK, CA

SUITE 185

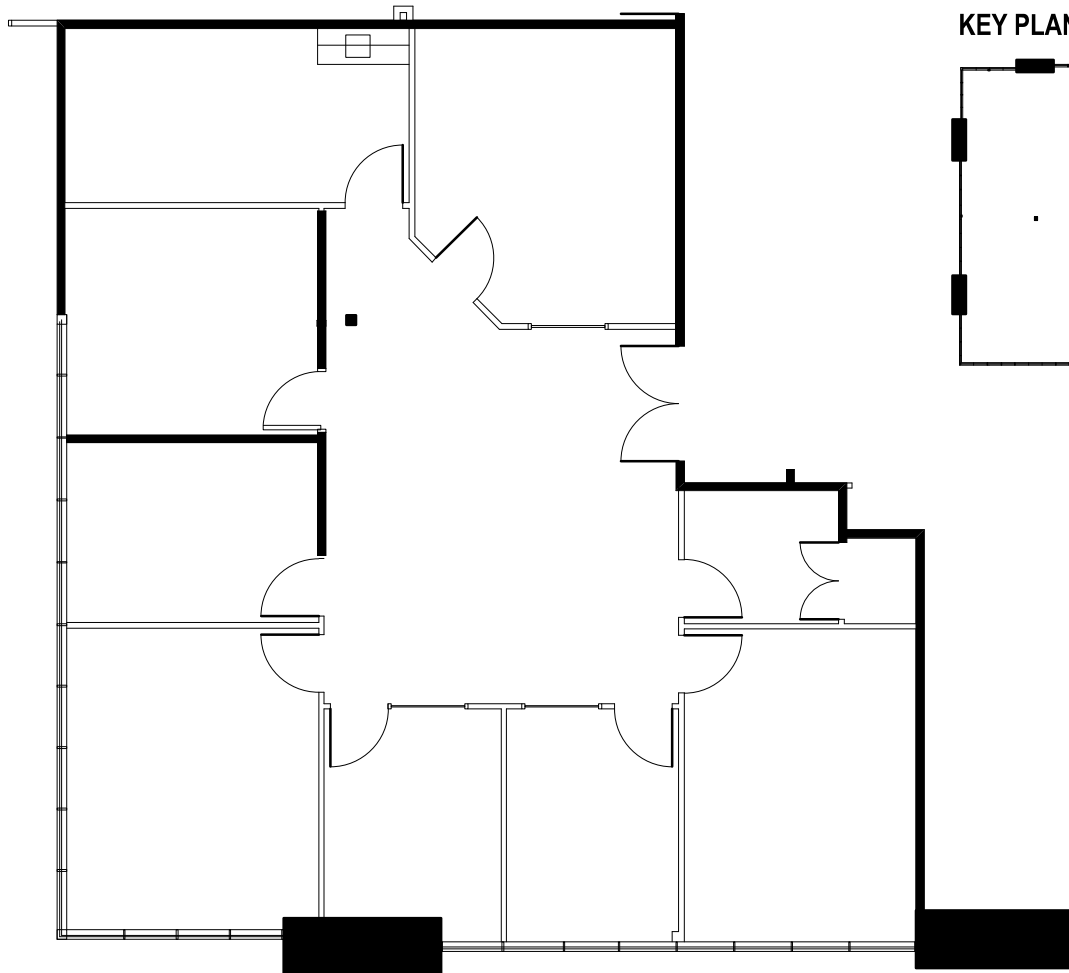

KEY PLAN SOUTH BUILDING - FLOOR 1

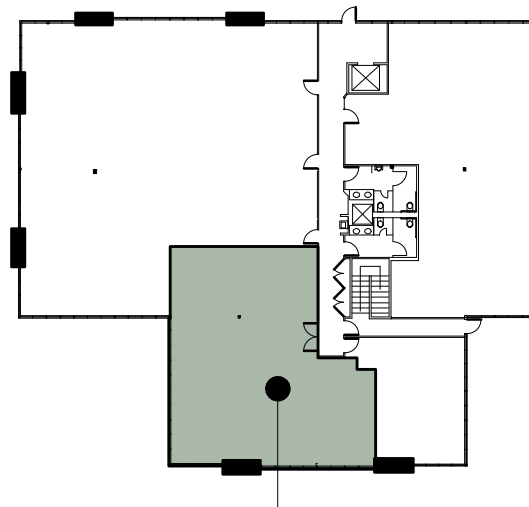

SUITE FLOOR LOCATION